



RESTROOM FRONT VIEW


BarnWood Texture on Exterior Walls. Color to be determined by Owner.

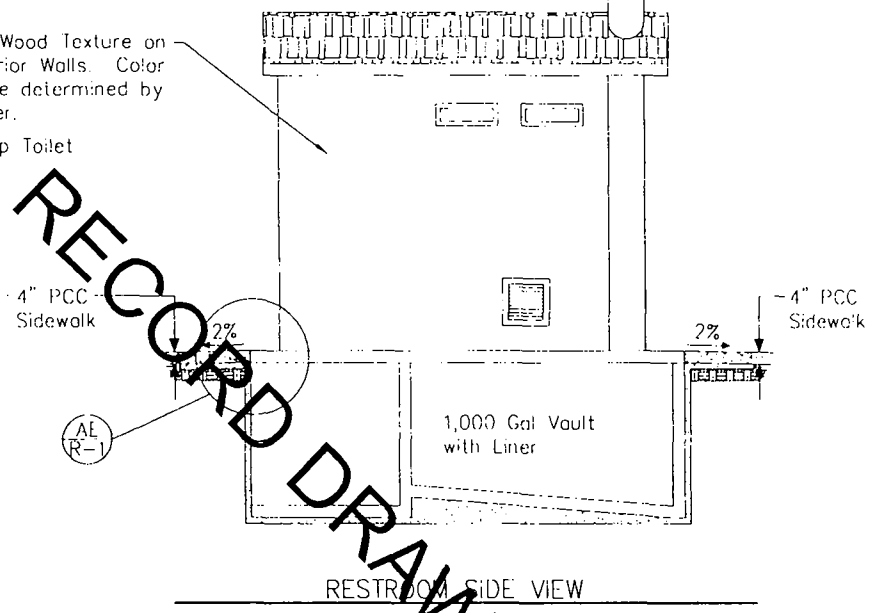


RESTROOM SIDE VIEW

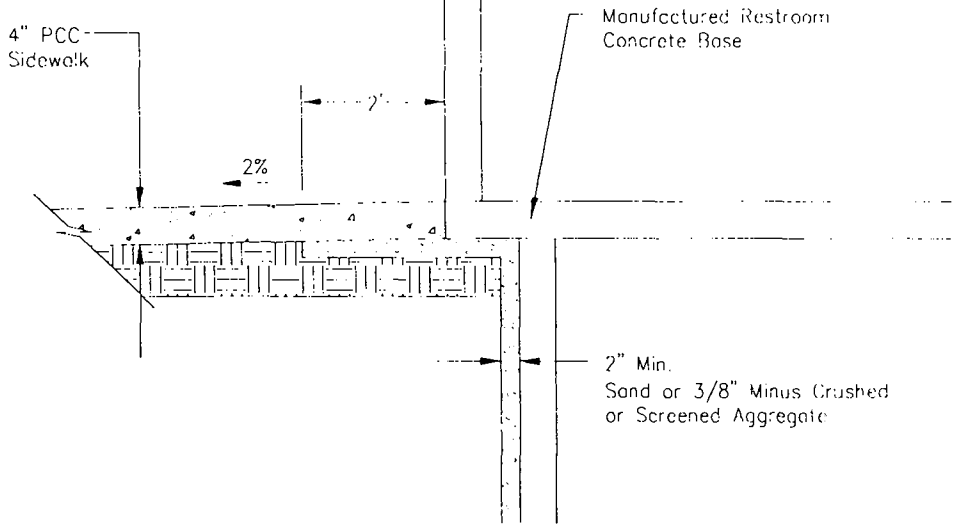

AE BUILDING PAD DETAIL

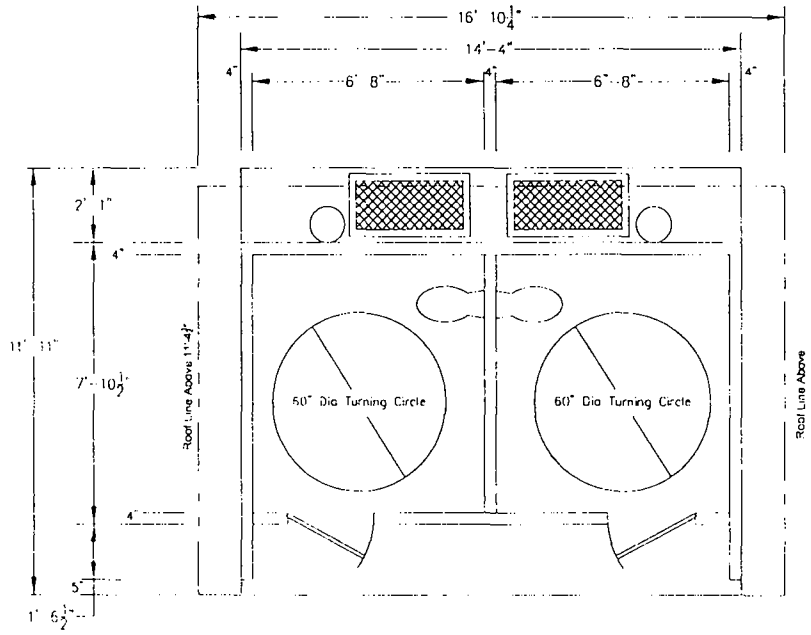

RESTROOM FLOOR PLAN

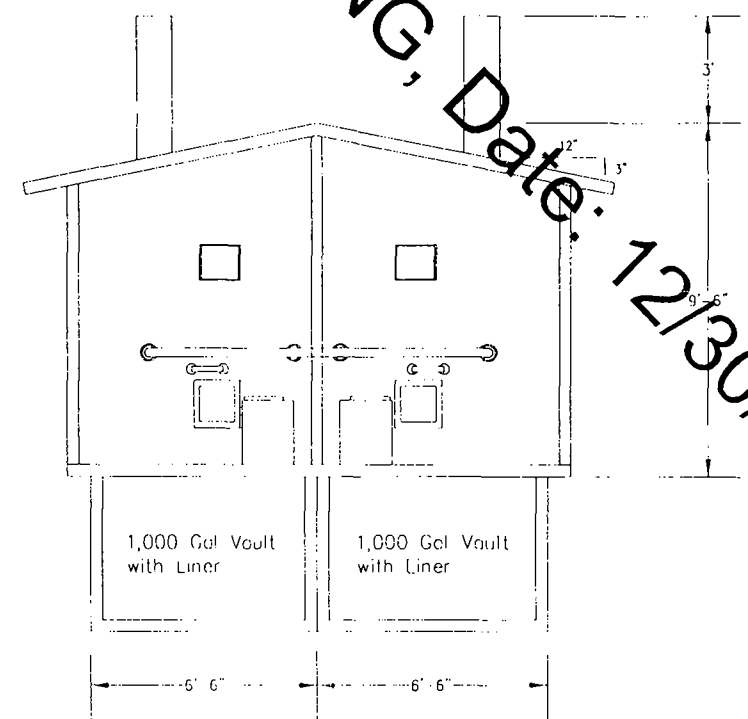

RESTROOM CROSS SECTION

RECORD DRAWING, Date: 12/30/05

NOTES:

1. USE CXT PRECAST TIIGA SPECIAL STYLE RESTROOM OR PRIOR APPROVED EQUAL.
2. SEE ELECTRICAL SHEETS FOR LIGHT LOCATIONS.



REV	DATE	BY	APPR	DESCRIPTION

DESIGNED BY	K. DOGID
DRAWN BY	K. DOGID
CHECKED BY	S. MINARD
IN CHARGE	J. M. SMITH
DATE	6-21-04

**VERIFY SCALE**  
 BAR IS ONE INCH ON ORIGINAL DRAWING  
 IF NOT ONE INCH ON THIS SHEET, ADJUST SCALES ACCORDINGLY

**M.H.M. INC.**  
 ENGINEERING - SURVEYING  
 525 "J" STREET  
 MARYSVILLE, CALIF. 95901  
 Phone: (530) 742-6400 / Fax: (530) 742-3400

**YUBA COUNTY WATER AGENCY**  
 COTTAGE CREEK PARKING LOT IMPROVEMENTS

COTTAGE CREEK  
 RESTROOM PLAN

STATE OF ORIGINAL	1" = 1' HORIZ	1" = 1' VERT
DRAWING NO.	R 1	SHEET 19

SHOWN R-11 FERC # 2246-045