Unofficial FERC-Generated PDF of 20060802-4001 Received by FERC OSEC 08/02/2006 in Docket#: P-2246-045

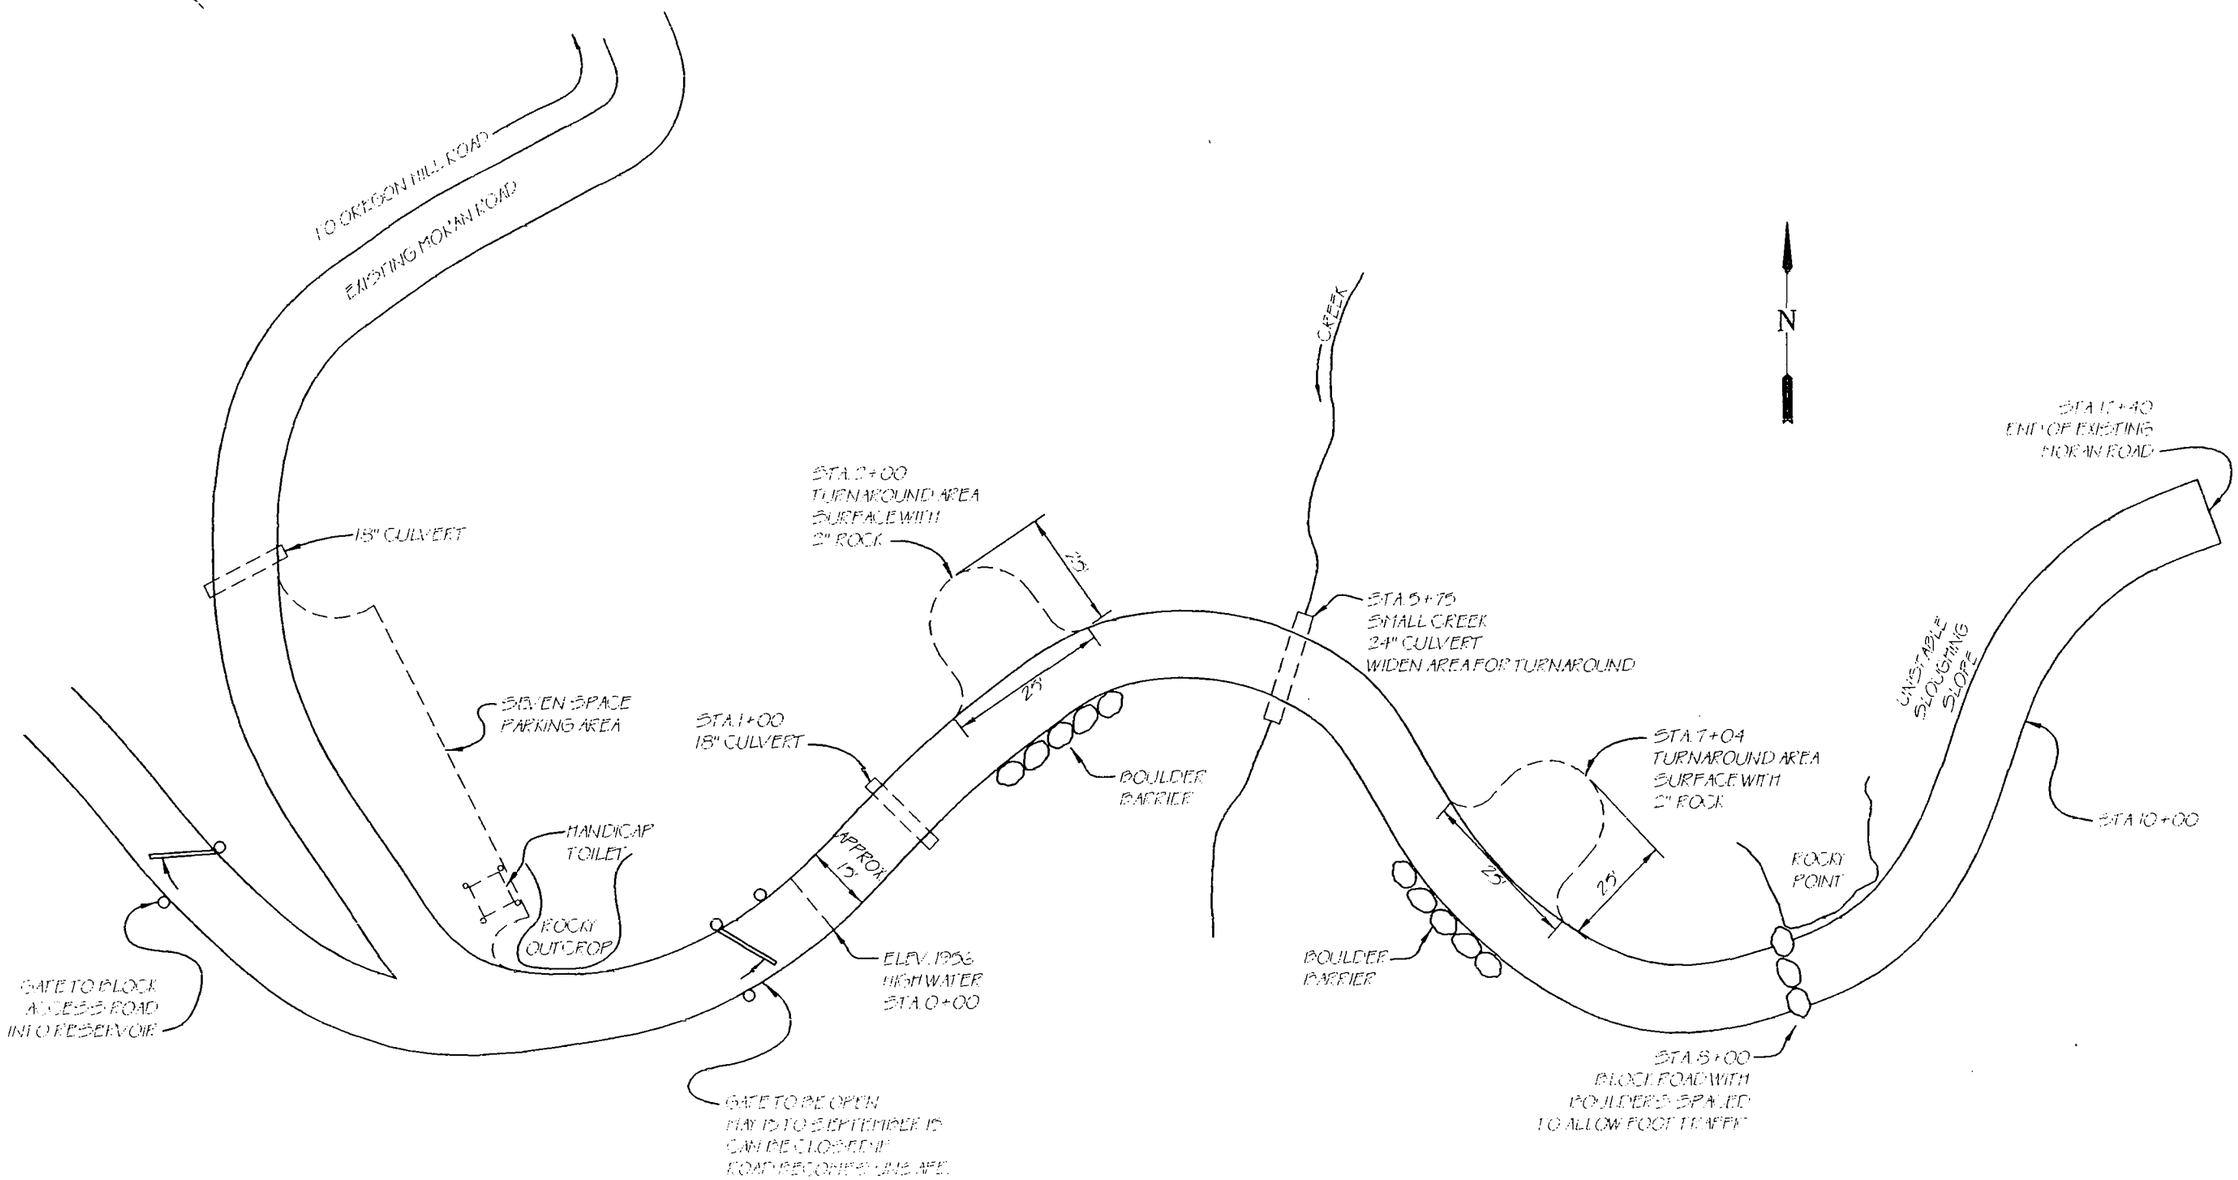

NO.	DATE	MADE	DRAWN	CHKD.
5				
4				
3				
2				
1	10-1-04 As Built	RDB	RDB	

REVISIONS

MORAN ROAD PROJECT
PROPOSED WORK TO BE DONE

YUBA COUNTY WATER AGENCY
DOBBINS, CA

SCALE: NOT TO SCALE | DRAWN BY: RDB

DATE: NOV. 20, 2002 | RO

EXHIBIT R-9 FERC# 2246-156